


### Encroachment Detail

Scale: 1"=50'

\* To be Moved

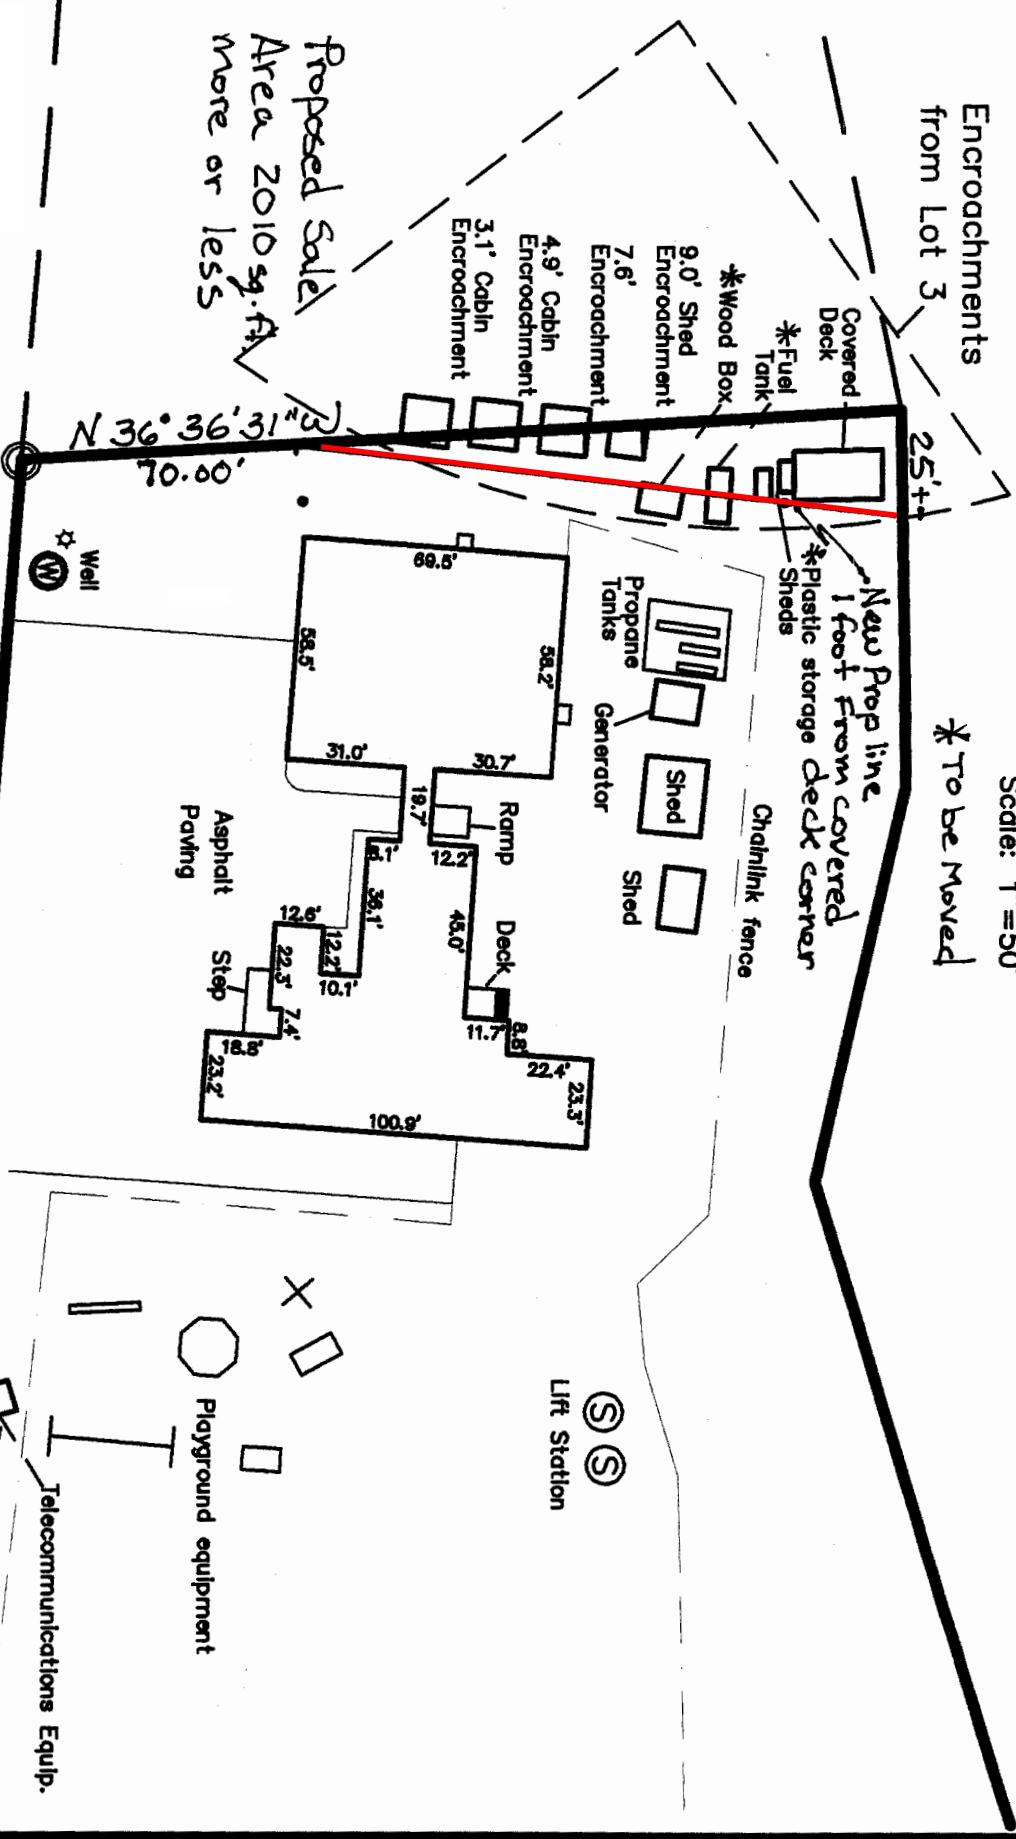

Proposed Sale Area 2010 sq. ft. more or less

$N 36^{\circ} 36' 31'' W$   
70.00'

Well

New Prop line 1 foot from covered  
\* Plastic storage deck corner



Chainlink fence

Lift Station


Asphalt Paving

Playground equipment

Telecommunications Equip.

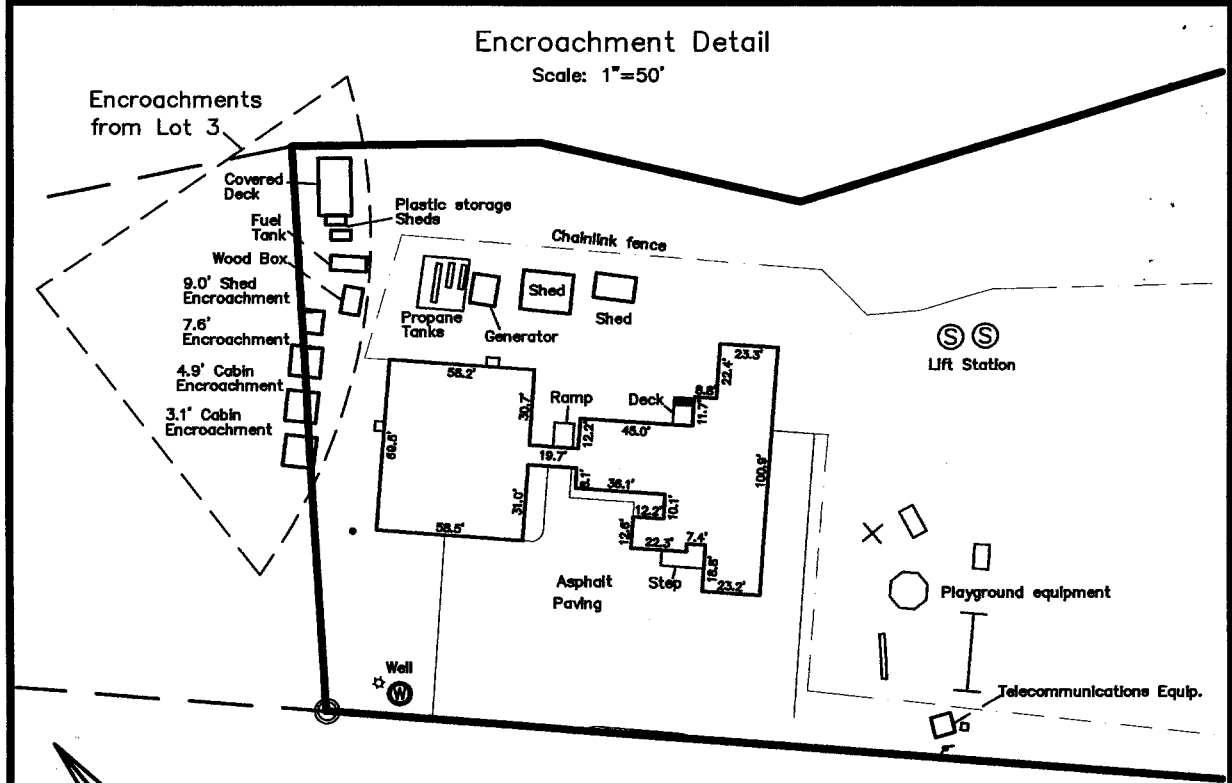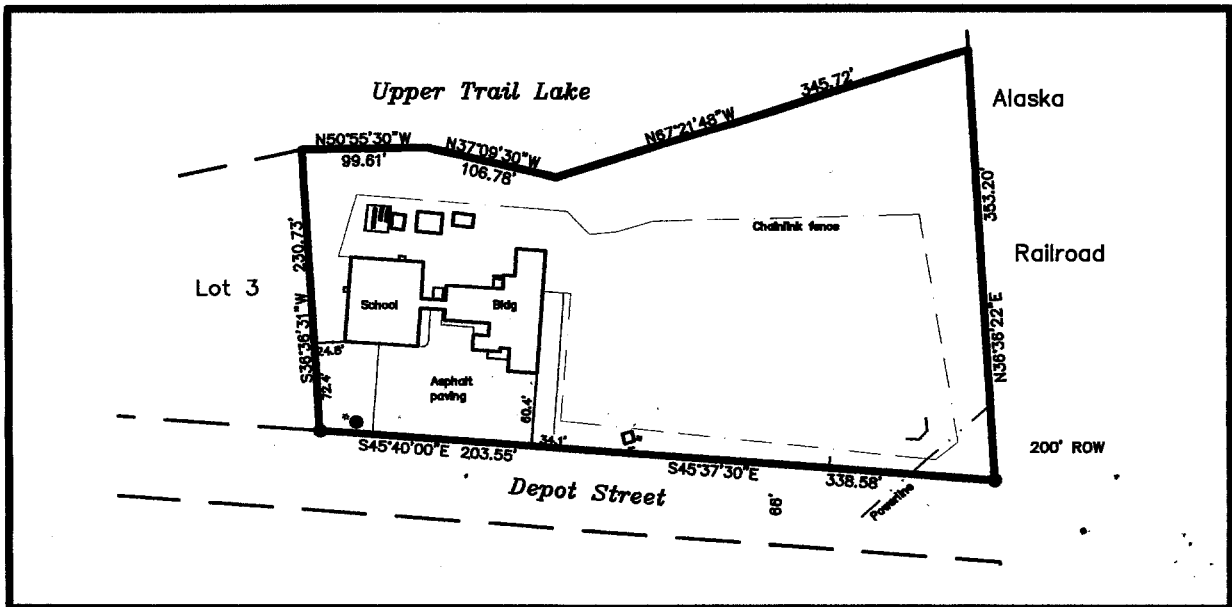

**ASBUILT CERTIFICATION**

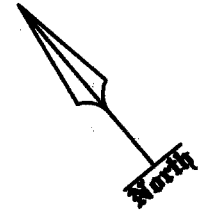

<b>LEGEND</b>		I hereby certify that I have surveyed the following described property: <u>Tract A</u> <u>Moose Pass School Site</u>
○ Found Pipe		
KENAI RECORDING DISTRICT	Plat: 74-3	and that no encroachments exist except as indicated hereon.
Date: 11-14-07	Scale: 1"=100'	
Job: 07123	Book: 07-6	<b>Exclusion Note:</b>
<b>SEGESSER SURVEYS</b> 30485 Rosland St. SOLDOTNA, AK 99669 (907) 262-3909		It is the responsibility of the Owner to determine the existence of any easements, covenants, or restrictions which do not appear on the recorded subdivision plat. Under no circumstances should any data hereon be used for construction or for establishing boundary or fence lines.

